


This drawing is copyrighted and is not to be reproduced without permission.
Do not scale from drawing. All dimensions are in millimetres unless otherwise indicated.
All dimensions to be checked prior to commencement of works.
Discrepancies to be reported for confirmation.
To be read in conjunction with all additional relevant drawings, specifications and manufacturer's instructions.
All products identified are 'or similar approved'

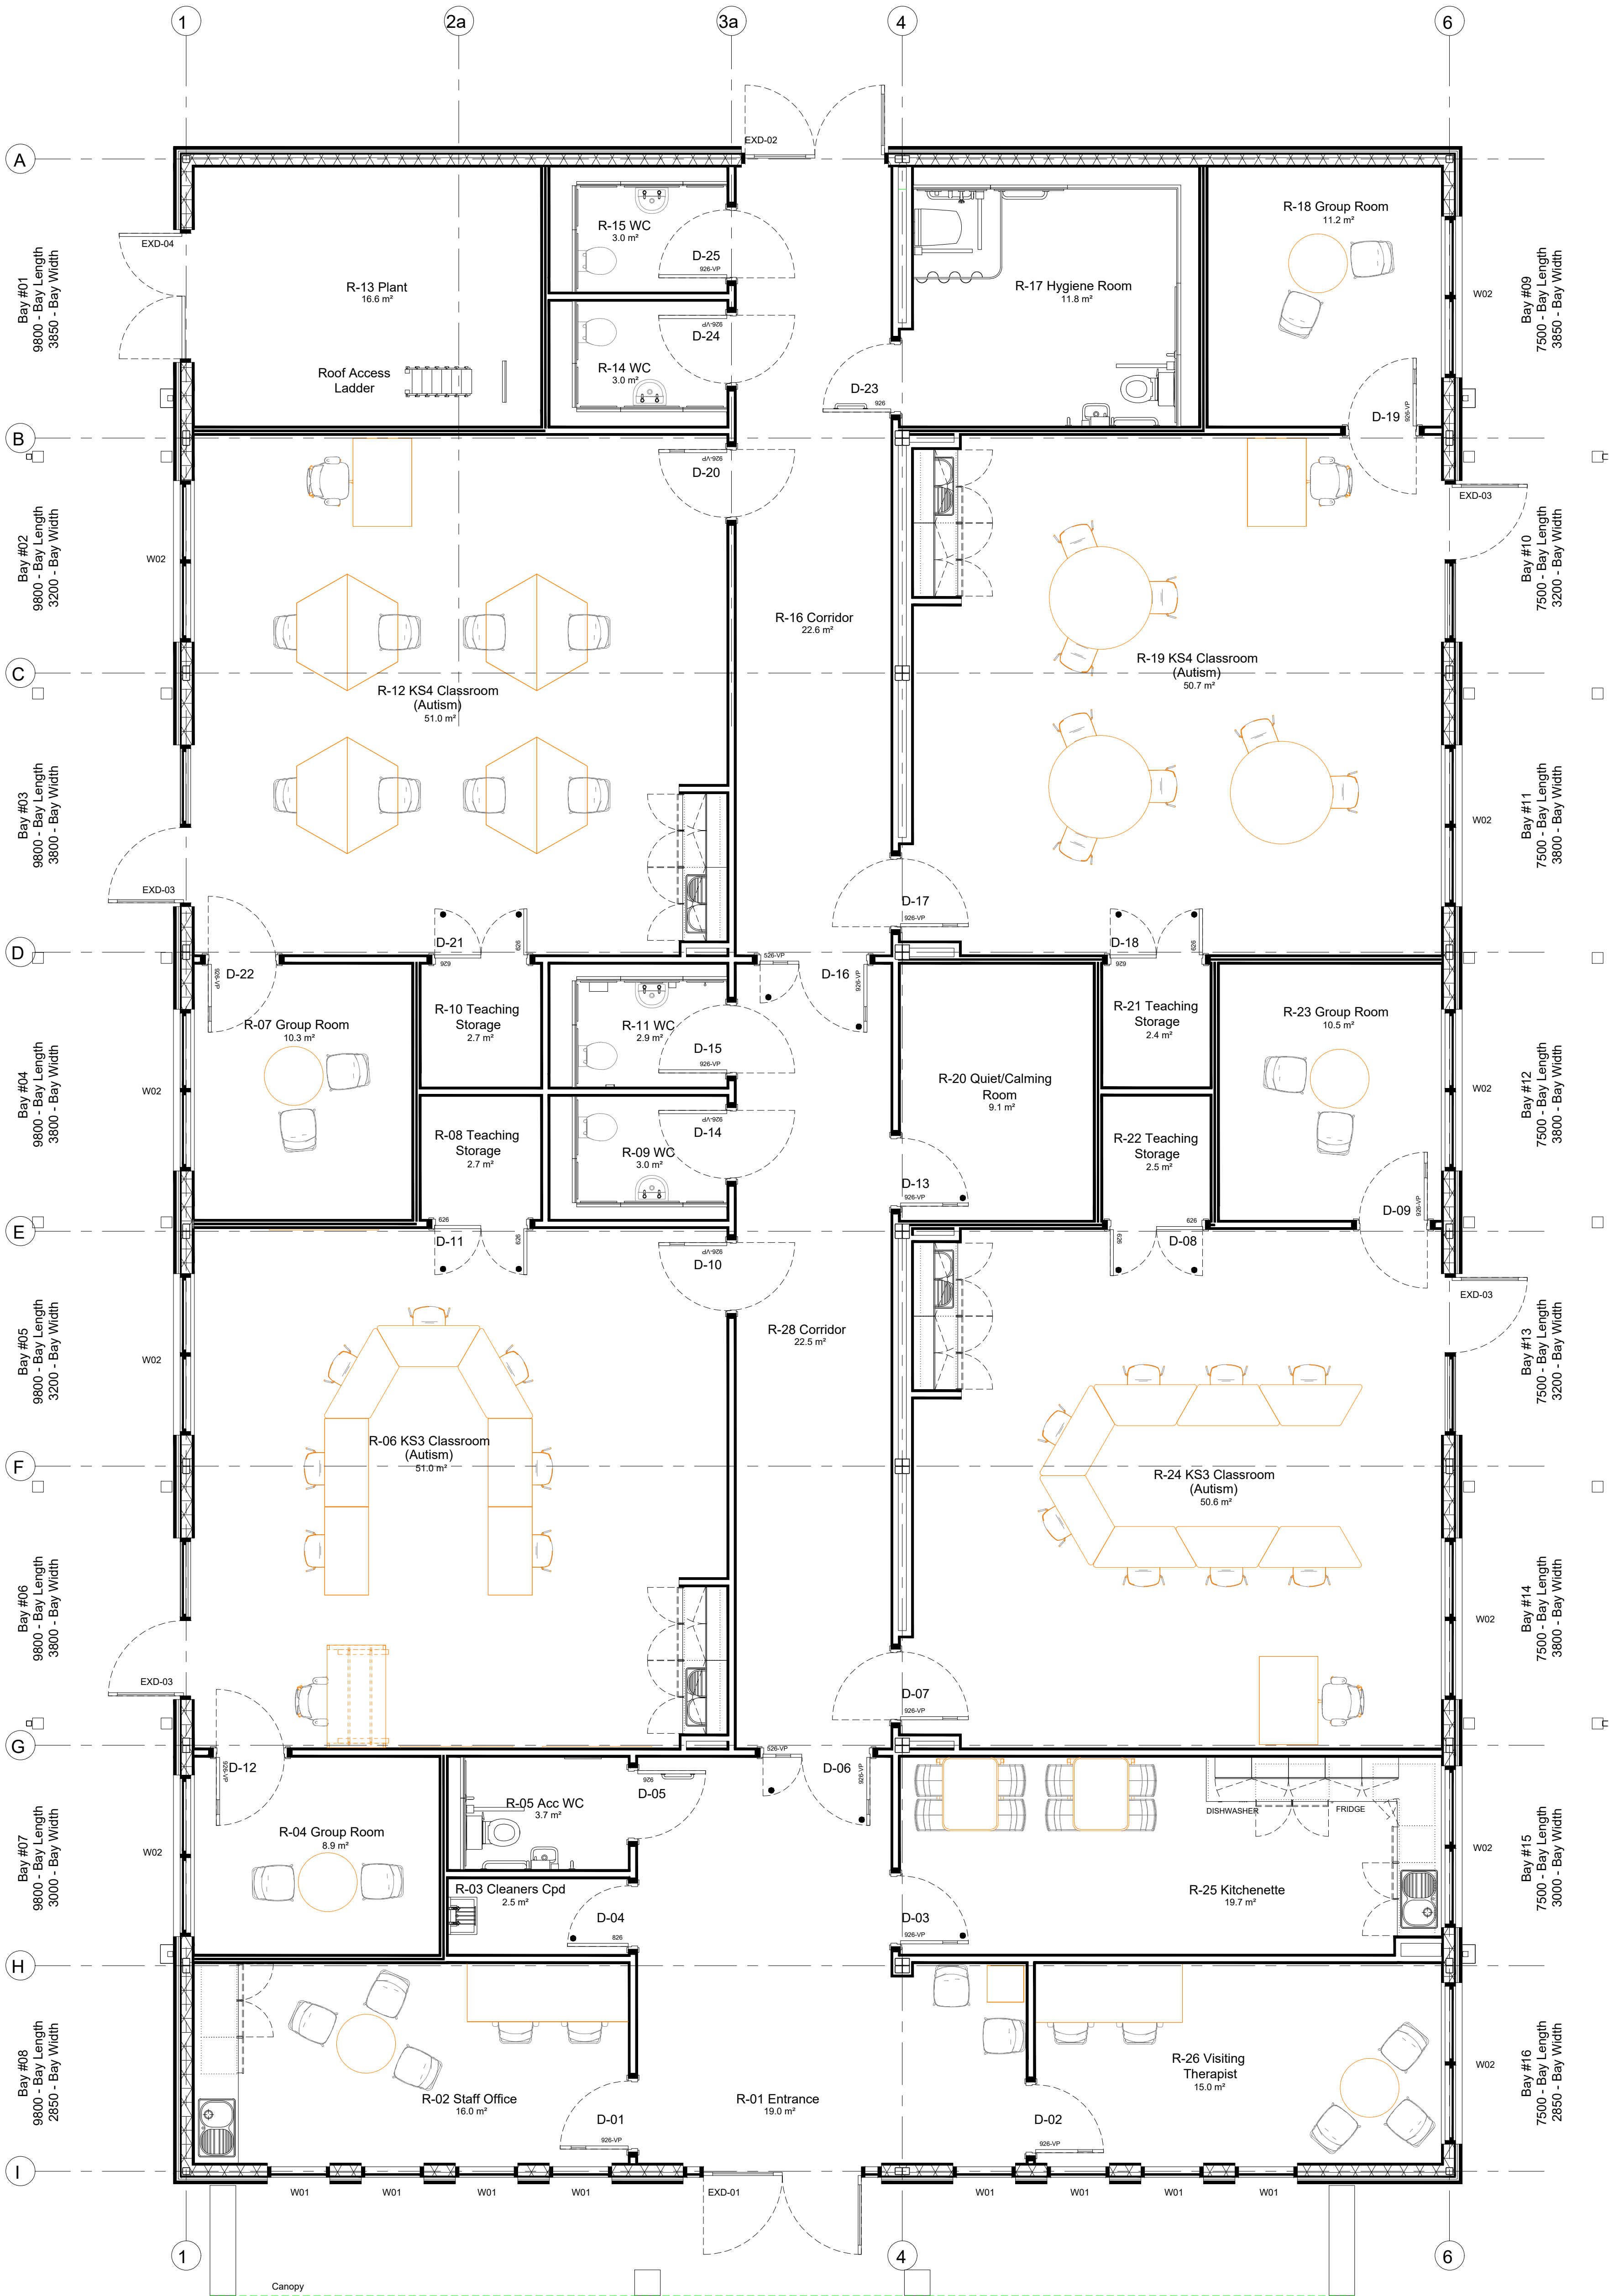

AB 30.01.25 AS BUILT SKETCH	BD NA
Rev Date Amendments	By Chk

Drawing Status:

AS BUILT



Rollalong Ltd.
Woolbridge Industrial Park,
Three Legged Cross,
Wimborne, Dorset.
BH21 6SF
www.rollalong.co.uk

Project Title:
COOMBE HOUSE SCHOOL

Drawing Title:
NEW CLASSROOM BLOCK

Contract No.:	Project / Production No.:	Rev.
	2324894	AB
Drawing No.:		
00-0100		
Date: 30.01.2025	Scale: N/A @ A1	
By: BD	Checked: NA	Approved: _____